

Date: Tuesday, 4/4/2006 1:26:43 PM
 User: Kim Johnston

Process Sheet

Customer	: CU-DAR001 Dart Helicopters Services	Drawing Name	: LITTER TIE DOWN ASS'Y
Job Number	: 26488		
Estimate Number	: 10360		
P.O. Number	: N/A	Part Number	: D2350
This Issue	: 4/4/2006	S.O. No.	: N/A
Prsht Rev.	: NC	Drawing Number	: D2350 / D2363
First Issue	: N/A	Project Number	: N/A
Previous Run	: 26442	Drawing Revision	: B / E
		Material	: N/A
Written By	: SEE COMMENT BELOW	Due Date	: 4/24/2006
Checked & Approved By	: 06.04.04	Qty:	4 Um: Each
Comment	:		

Additional Product

Job Number:



Seq. #:	Machine Or Operation:	Description :
---------	-----------------------	---------------

1.0

D6201

T Extrusion 4X4X3/8



Comment: Qty.: 1.0631 f(s)/Unit Total: 4.2525 f(s)

Material: D6201 (6061-T6 (QQ-A-200/8) 4" x 4" x 3/8" Thick 'T' extrusion

Batch: A 26538

2.0

BAND SAW

BAND SAW



Comment: BAND SAW

Cut blanks: 12.150" long

SA 06.05.06

4

3.0

HAAS1

HAAS CNC VERTICAL MACHINING #1



Comment: HAAS CNC VERTICAL MACHINING #1

Machine as per Folio D2363 and Dwg D2363

SA 06.05.06

4

4.0

QC2

INSPECT PARTS AS THEY COME OFF MACHINE



Comment: INSPECT PARTS AS THEY COME OFF MACHINE

SA 06.05.06

4

5.0

QC8

SECOND CHECK



Comment: SECOND CHECK

J.G 06/05/08 4

6.0

HAAS1

HAAS CNC VERTICAL MACHINING #1



Comment: HAAS CNC VERTICAL MACHINING #1

Tumble & deburr

SA 06.05.06

4

Dart Aerospace Ltd

W/O:		WORK ORDER CHANGES					
DATE	STEP	PROCEDURE CHANGE	By	Date	Qty	Approval Chief Eng / Prod Mgr	Approval QC Inspector

Part No: _____ PAR #: _____ Fault Category: _____ NCR: Yes No DQA: _____ Date: _____

QA: N/C Closed: _____ Date: _____

NCR:		WORK ORDER NON-CONFORMANCE (NCR)						
DATE	STEP	Description of NC Section A	Corrective Action Section B			Verification Section C	Approval Chief Eng	Approval QC Inspector
			Initial Chief Eng	Action Description Chief Eng	Sign & Date			

NOTE: Date & initial all entries

Date: Tuesday, 4/4/2006 1:26:43 PM
User: Kim Johnston

Process Sheet

Customer: CU-DAR001 Dart Helicopters Services

Drawing Name: LITTER TIE DOWN ASS'Y

Job Number: 26488

Part Number: D2350

Job Number:



Seq. #:

Machine Or Operation:

Description :

7.0

QC5

INSPECT WORK TO CURRENT STEP



Comment: INSPECT WORK TO CURRENT STEP

8.0

HAND FINISHING1

HAND FINISHING RESOURCE #1



Comment: HAND FINISHING RESOURCE #1

Chemical Conversion Coat as per QSI 005 4.1

H.M 06/05/09

9.0

POWDER COATING

POWDER COATING



Comment: POWDER COATING

Powder Coat White Gloss (Ref: 4.3.5.1) as per QSI 005 4.3

Q.m 06-05-16

10.0

QC3

INSPECT POWDER COAT/CHEMICAL CONVERSION



Comment: INSPECT POWDER COAT/CHEMICAL CONVERSION

11.0

D2372

Quick Release



Comment: Qty.: 2.0000 Each(s)/Unit Total : 8.0000 Each(s)

Pick: Assembly Kit

Qty Part Number Description Batch

2 D2372

Fastener

B19507

12.0

D2444

Pip Pin Assembly



Comment: Qty.: 1.0000 Each(s)/Unit Total : 4.0000 Each(s)

Pick: Assembly Kit

Qty Part Number Description Batch

1 D2444

Pip Pin

B25824

13.0

AN960JD10L

Washer



Comment: Qty.: 3.0000 Each(s)/Unit Total : 12.0000 Each(s)

Pick: Assembly Kit

Qty Part Number Description Batch

3 AN960JD10L

Washer

M18235

Dart Aerospace Ltd

W/O:		WORK ORDER CHANGES					
DATE	STEP	PROCEDURE CHANGE	By	Date	Qty	Approval Chief Eng / Prod Mgr	Approval QC Inspector

Part No: _____ PAR #: _____ Fault Category: _____ NCR: Yes No DQA: _____ Date: _____
 QA: N/C Closed: _____ Date: _____

NCR:		WORK ORDER NON-CONFORMANCE (NCR)						
DATE	STEP	Description of NC Section A	Corrective Action Section B			Verification Section C	Approval Chief Eng	Approval QC Inspector
			Initial Chief Eng	Action Description Chief Eng	Sign & Date			

NOTE: Date & initial all entries

Date: Tuesday, 4/4/2006 1:26:43 PM
User: Kim Johnston

Process Sheet

Customer: CU-DAR001 Dart Helicopters Services

Drawing Name: LITTER TIE DOWN ASS'Y

Job Number: 26488

Part Number: D2350

Job Number:



Seq. #:

Machine Or Operation:

Description :

14.0

MS21042L3

Nut



Comment: Qty.: 1.0000 Each(s)/Unit Total : 4.0000 Each(s)

Pick: Assembly Kit

Qty Part Number Description Batch

1 MS21042L3

Nut (or -3)

M15917

15.0

MS27039113

Screw



Comment: Qty.: 1.0000 Each(s)/Unit Total : 4.0000 Each(s)

Pick:

Qty Part Number Description Batch

1 MS27039-1-13

Screw

M13719

SAP 05:05:17

16.0

QC5

INSPECT WORK TO CURRENT STEP



Comment: INSPECT WORK TO CURRENT STEP

17.0

PACKAGING 1

PACKAGING RESOURCE #1



Comment: PACKAGING RESOURCE #1

Identify and Stock

Location: ST171

6/4/19 (4)

18.0

DC

DOCUMENT CONTROL



Comment: DOCUMENT CONTROL

Inspection Level 21

06/05/23 (4)

Job Completion



U 06.05.23

Dart Aerospace Ltd

W/O:		WORK ORDER CHANGES					
DATE	STEP	PROCEDURE CHANGE	By	Date	Qty	Approval Chief Eng / Prod Mgr	Approval QC Inspector
06-05-17	15.1	Assy as per Dwg. Add to Estimate - permanent change <i>[Signature]</i> 06-05-17	SAD	06-05-17	4	<i>[Signature]</i> 06-05-17	<i>[Signature]</i> 06-05-17

Part No: _____ PAR #: _____ Fault Category: _____ NCR: Yes ☐ No ☒ DQA: ☒ Date: 06-05-17
 QA: N/C Closed: _____ Date: _____

NCR:		WORK ORDER NON-CONFORMANCE (NCR)						
DATE	STEP	Description of NC Section A	Corrective Action Section B			Verification Section C	Approval Chief Eng	Approval QC Inspector
			Initial Chief Eng	Action Description Chief Eng	Sign & Date			
06-05-17	4 15.1	1x D2372 was damaged by the drill chuck, when removing the puncher out of the pip pin holes.	<i>[Signature]</i> 06-05-17	Scrap & replace 1x D2372.	SAD 06-05-18	<i>[Signature]</i> 06-05-17	<i>[Signature]</i> 06-05-17	<i>[Signature]</i> 06-05-17

NOTE: Date & initial all entries



DESIGN B WILLIAMS	DRAWN BY B WILLIAMS	DART AEROSPACE LTD VICTORIA INTERNATIONAL AIRPORT, CANADA	
CHECKED BW	APPROVED <i>[Signature]</i>	DRAWING NO. D2350	REV. B SHEET 1 OF 2
DATE 95:02:20		TITLE LITTER TIE DOWN ASSEMBLY SCALE	

RELEASED
960607

D2350	Part No.	Description
X	D2350	LITTER TIE DOWN ASSEMBLY (NON-LOCKING)
1	D2363	LITTER TIE DOWN (NON-LOCKING)
2	D2372	QUICK RELEASE FASTENER
1	D2444	PIP PIN
<i>X</i> 3	AD960JD10 L	WASHER
1	MS21042L3	NUT
1	MS27039-A-13	SCREW

KE 99.04.29



SHOP COPY
RETURN TO
ENGINEERING
UNCONTROLLED COPY
SUBJECT TO AMENDMENT
WITHOUT NOTICE
WORK ORDER
NO. 26488

DART



DESIGN	DRAWN BY	DART AEROSPACE LTD VICTORIA INTERNATIONAL AIRPORT, CANADA	
B WILLIAMS	B WILLIAMS	DRAWING NO.	REV. B
CHECKED <i>BW</i>	APPROVED <i>[Signature]</i>	D2350	SHEET 2 OF 2
DATE		TITLE	SCALE
95:02:20		LITTER TIE DOWN ASSEMBLY	

RELEASED
960607

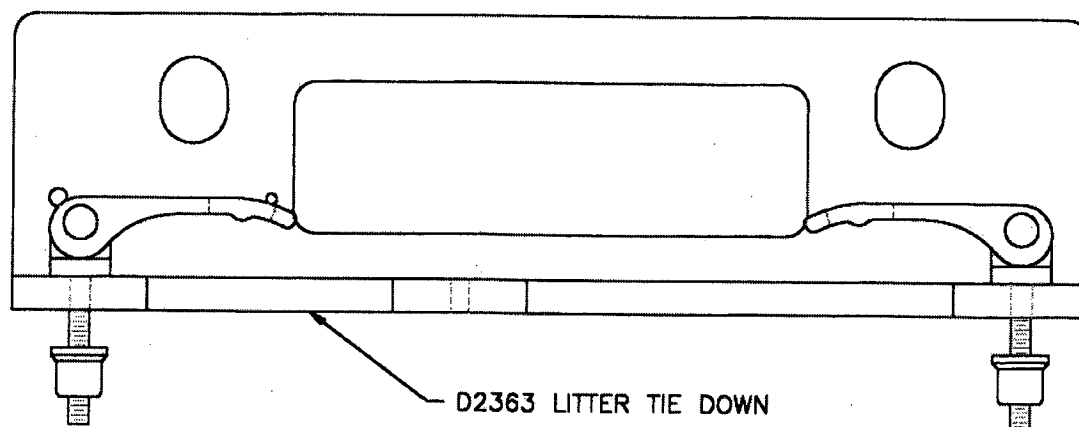
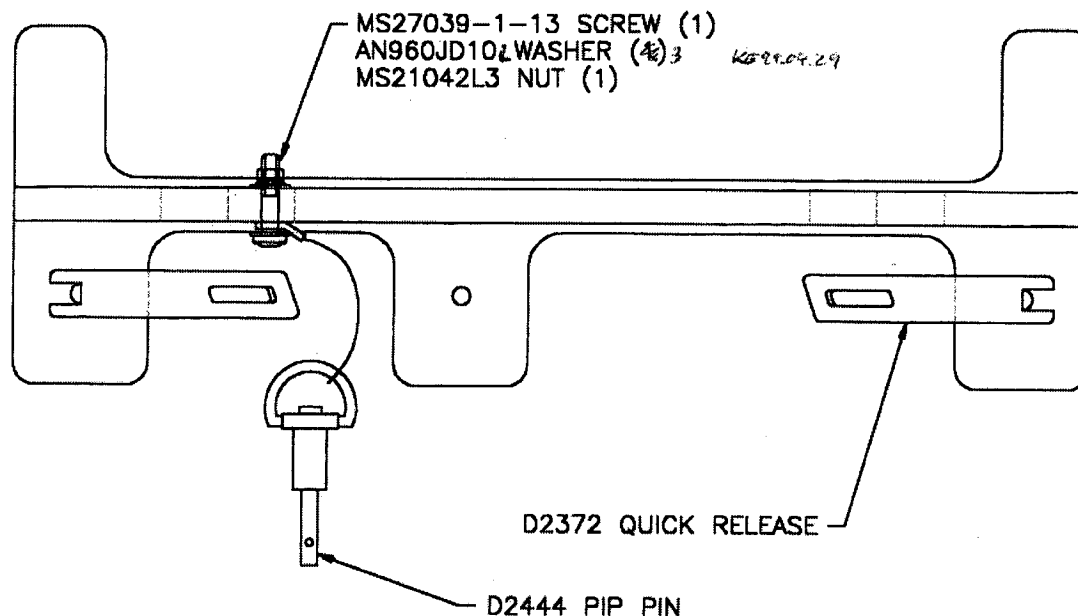


SHOP COPY
RETURN TO
ENGINEERING
UNCONTROLLED COPY
SUBJECT TO AMENDMENT
WITHOUT NOTICE
WORK ORDER
NO. 26488

DART

DESIGN BW	DRAWN BY KE	DART AEROSPACE LTD VICTORIA INTERNATIONAL AIRPORT, CANADA	
CHECKED DIOY	APPROVED BW	DRAWING NO. D2363	REV. E SHEET 1 OF 1
DATE 97.10.01		TITLE LITTER TIE DOWN BRACKET	SCALE 1:2
A	95.01.14	NEW ISSUE	
B	95.02.14	MODIFIED HOLES	
C	95.03.06	0.191 WAS 0.197	
D	95.03.06	CHANGES TO DIMENSIONS	
E	97.10.01	CHANGES FOR MACHINING	

RELEASED
971003 KE
TSR A129

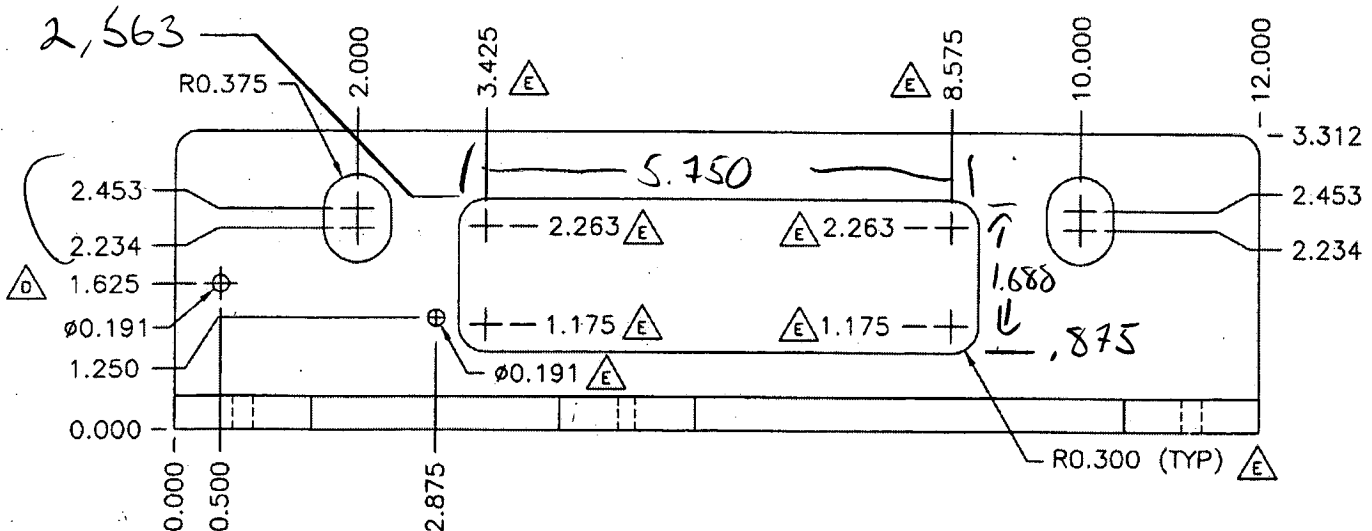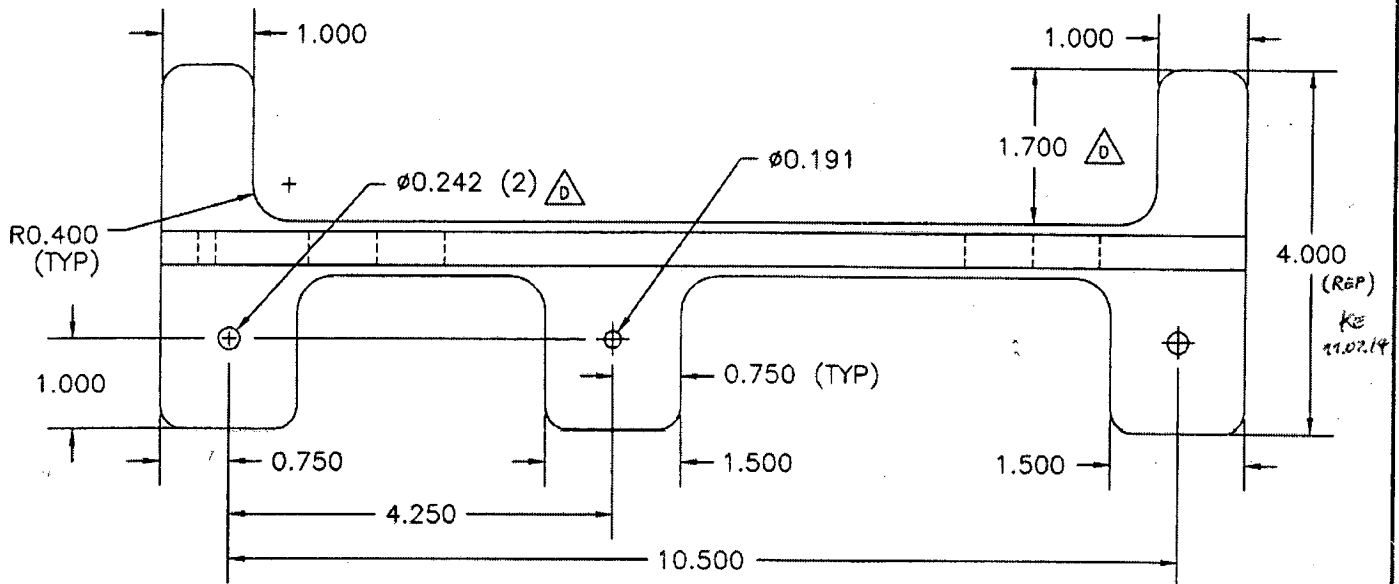

MATERIAL: 6061-T6 (QQ-A-200/8) 4X4X3/8 'T' SECTION
FINISH: ANODIZE

SHOP COPY
RETURN TO
ENGINEERING
UNCONTROLLED COPY
SUBJECT TO AMENDMENT
WITHOUT NOTICE

Copyright 1995 by DART AEROSPACE LTD

WORK ORDER
NO. 26488

